

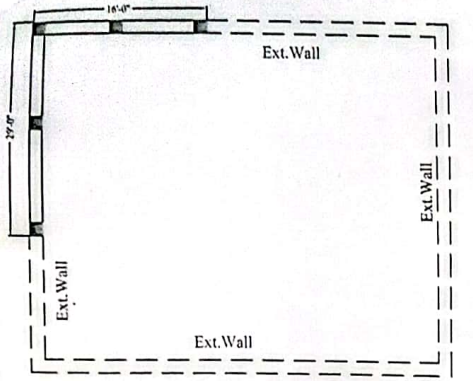


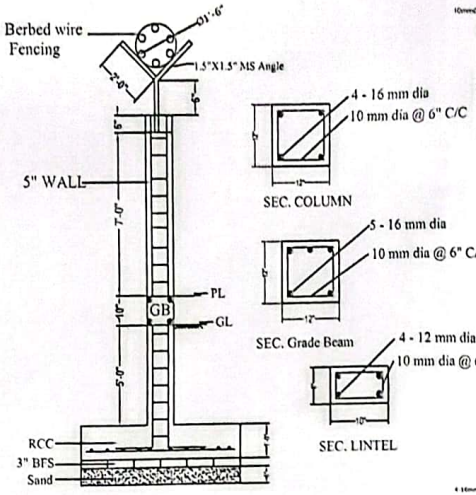


SEC. COLUMN

SEC. Grade Beam


SEC. LINTEL

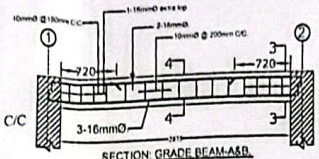


SECTION: GRADE BEAM-A&B
SCALE 1:50

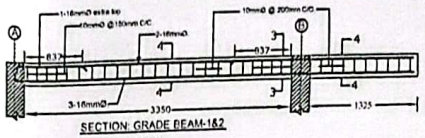


SECTION: GRADE BEAM-1&2
SCALE 1:50

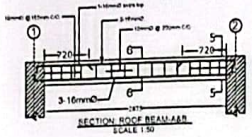


SECTION: ROOF BEAM-A&B
SCALE 1:50

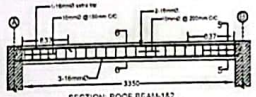


SECTION: ROOF BEAM-1&2
SCALE 1:50

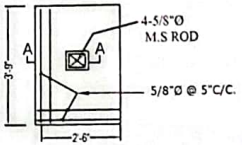


PLAN:COLUMN FOOTING

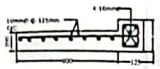


PORCH SECTION E-E
SCALE 1:50

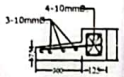


SUN SHADE WITH LINTEL
SCALE 1:50

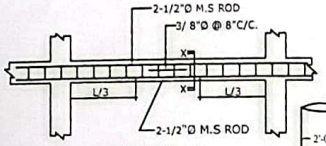



GRADE BEAM

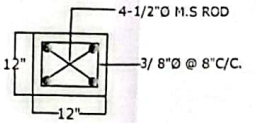

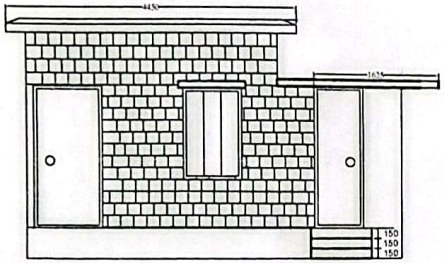


FRONT ELEVATION
SCALE 1:60

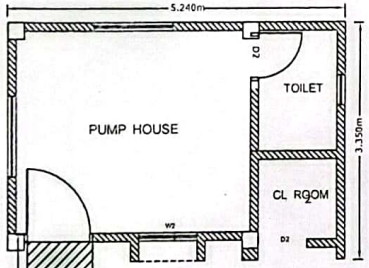


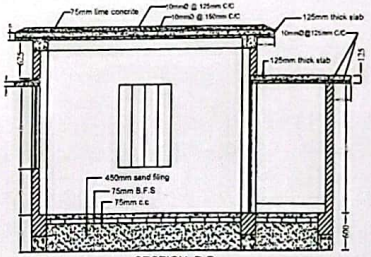


SECTION: D-D
SCALE 1:60

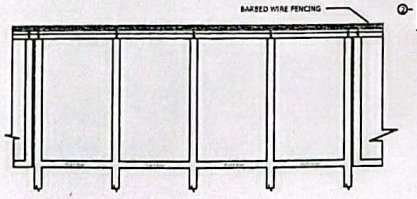


ELEVATION OF BOUNDARY WALL

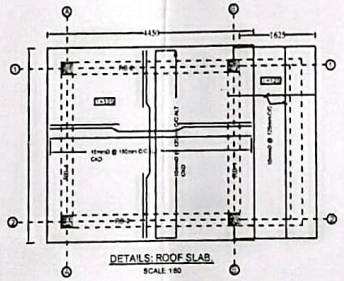


DETAILS: ROOF SLAB
SCALE 1:60

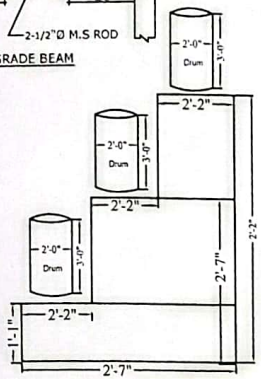


PLAN: BASE

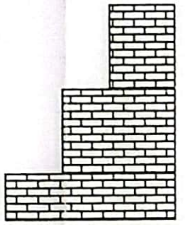

BASE FRONT ELEVATION

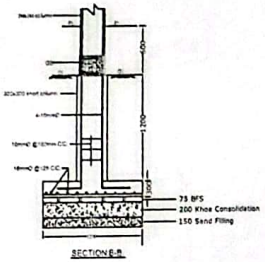

SECTION B-B

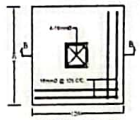

DETAILS RCC COLUMN
SCALE 1:40



"As-built drawing has been prepared as per Data provided by the working Division"

Name of Contractor - M/S. Himi Business Trade

Date of Completion - 25 - 10 - 25.(Monipuripara)

WORK DONE BY- Construction(Civil) Division			DRAWING PREPARED BY : -				
29/12/25	29/12/25	12/12/25	17/12/25		17/12/25	17.12.25	17-12-2025
Al-Mamun SAE	MD. Delwar Hossain AE	Monzurul Hasan E.E	Md. Sayedul Howladar Draftsman	Delwar Hossain Lasker Surveyor	Sakibuzzaman SAE	Md.Abdul Hannan SDE	S.M. Toufiqur Rahman E.E
Construction(Civil) Division			P&D (Water & Hydrology) Division, Dhaka WASA.				

Title

AS-Built Drawing for Re-Construction Boundary Wall & Pump House at Monipuripara Pump Compound with ancillary works under MODS Zone-3 DHAKAWASA.

Job no -M -14 /25-26

Reff. nr- 46.113.444.00. 00.075.24-25-260

CamScanner